


SCALE: 1/64"=1'-0"



SCALE: 1/16"=1'-0"

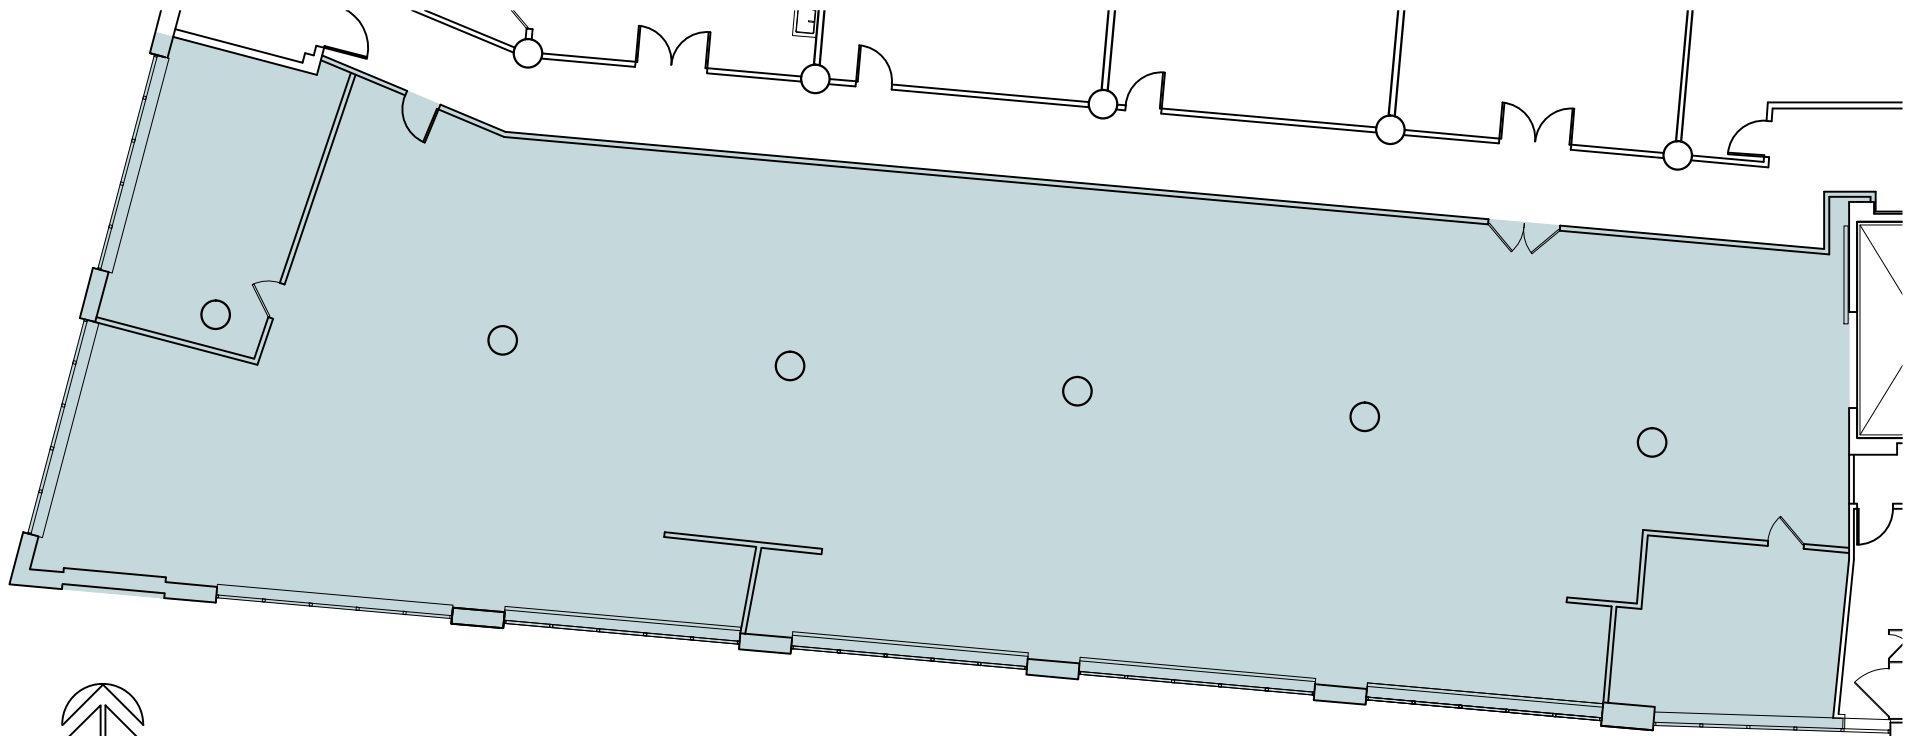

# AS-BUILT DESIGN SKETCH

37-18 Northern Blvd.  
3rd Floor S/W Side  
LIC, NY

PROJECT LOCATION B:\Construction\NewYork\37-18 3rd Floor\Regional\3rd Floor\Priv		FILE NAME 37-18 NORTHERN BLVD - 3rd Floor	PLOT DATE 01/14/15
DATE	Jan 14, 15	DRAWING NO.	
DRAWN BY	cbassal	DS-	