


GENERAL NOTES


THIS IS A PRELIMINARY PLAN FOR SPACE LAYOUT ONLY.
NOTES ON ALL CONSTRUCTION/ HVAC/ ELECTRIC/ CARPENTRY,
MILLWORK & GLASS WORK TO BE PERFORMED WILL BE ADDED
AS THE DESIGN PROGRESSES.

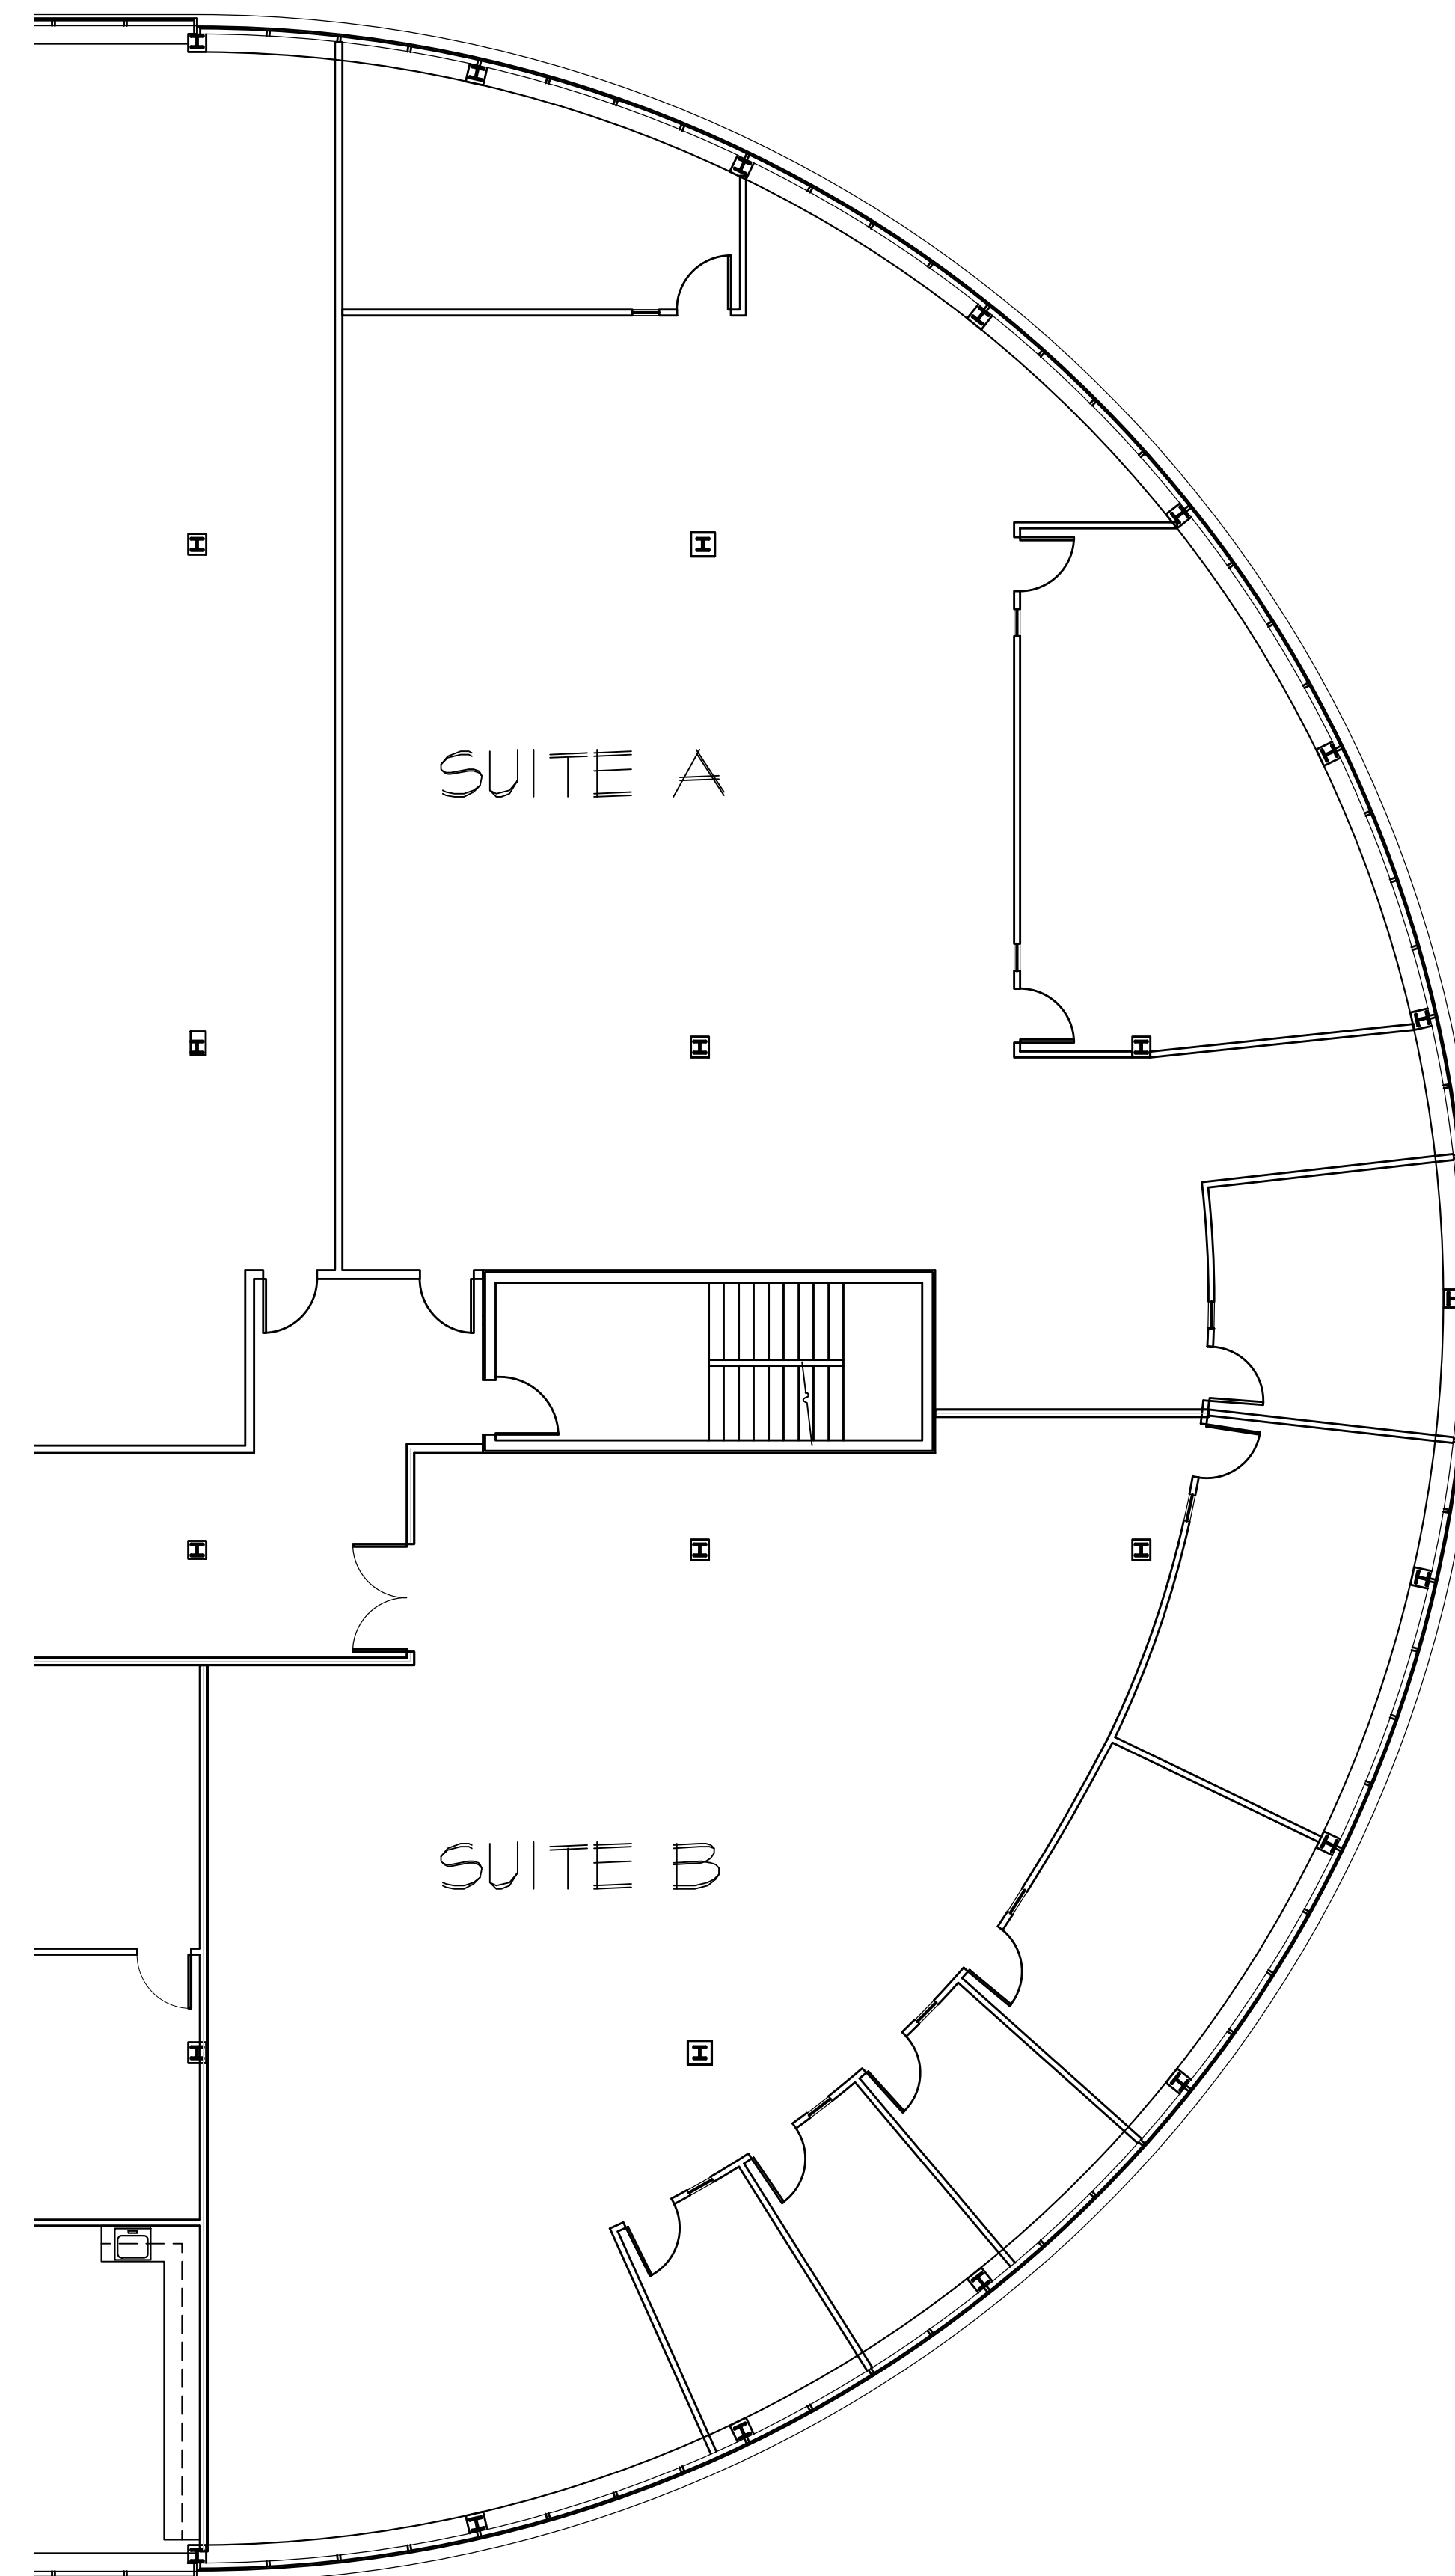

AS-BUILT PLAN

SCALE: 1/8" = 1'-0"

SUITE # 411 & 413
395 NORTH SERVICE RD
MELVILLE, NY 11747

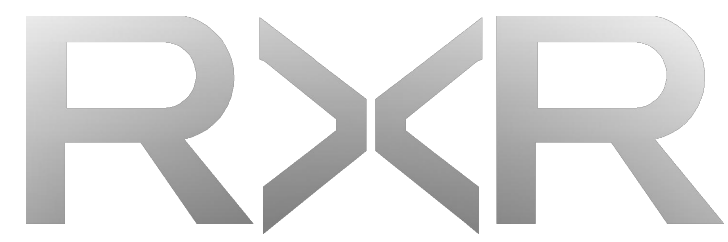

625 RXR PLAZA
UNIONDALE, NY 11556
(516) 506-6000

1	01/31/17	AB	AS-BUILT PLAN
NO.	DATE	BY	REVISION

THESE DRAWINGS HAVE BEEN PREPARED UNDER MY DIRECT SUPERVISION.

SEAL

PROJECT TITLE

SUITES 411
& 413

DRAWING TITLE

AS-BUILT FLOOR
PLAN

PROJECT LOCATION

FILE NAME	625 North Service Rd - As-Built Plan.dwg	FLAT DATE	Mar 28, 2017 - 5:11pm
DATE	Mar 28, 17	DRAWING NO.	A-1
DRAWN BY	abershatky		
SCALE	AS NOTED		
ACT. #	xxxxx		