


SUITE # 401
 48 SOUTH SERVICE ROAD
 MELVILLE, NY

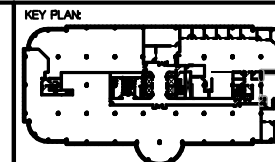

FILE NAME: 48-401-Vacant Suite-020118.dwg
FILE: \\server\engineering\vacant\48 South Service Rd\48-401-Vacant Suite-020118.dwg
DRAWN BY: EM
SCALE: 1/8"=1'-0"
DATE: Jan 17, 2018
DRAWING NUMBER: EX-1