


**SUITE #310**  
**300 EXECUTIVE DRIVE**  
**WEST ORANGE NJ.**

KEY PLAN:

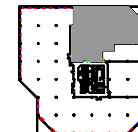

FILE NAME: 300-310.dwg
FILE: C:\West Orange\300 EXECUTIVE DRIVE\Regen\310.dwg
DRAWN BY: DB
SCALE: N/A
DATE: Feb 28, 2011
DRAWING NUMBER:

**EX-1**