


**SUITE # 180**  
**100 EXECUTIVE DRIVE**  
**WEST ORANGE, N.J.**

KEY PLAN

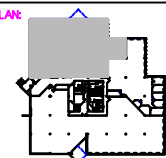

FILE NAME: 100-180.dwg  
 FILE: G:\West Jersey\100 EXECUTIVE DRIVE\Regional\ASBULTY  
 DRAWN BY: XY  
 SCALE: 1/8"=1'-0"  
 DATE: Mar 19, 2010  
 DRAWING NUMBER:

**EX-1**