


SUITE #103-8,987 RSF  
100 CAMPUS DRIVE  
WEST WINDSOR, N.J.

KEY PLAN:

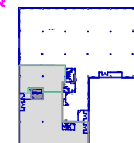

FILE NAME:	100_103.dwg
FILE:	G:\New Jersey\100 CAMPUS DRIVE\Regional\Aerial\
DRAWN BY:	DB
SCALE:	N/A
DATE:	JUN 17, 2015
DRAWING NUMBER:	

EX-1