


FIRST FLOOR
 10 ROONEY CIRCLE
 WEST ORANGE, NJ

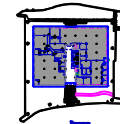

KEY PLAN



FILE NAME: 1st_Floor Alling	EX-1
FILE: G:\New Jersey\10 Rooney Circle\Regional\asbuilt	
DRAWN BY: DB	
SCALE: N/A	
DATE: Aug 22, 2011	
DRAWING NUMBER	