




SUITE #110- AS BUILT UNIVERSITY SQUARE PRINCETON, N.J.

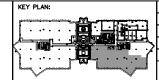

FILE NAME: 1U_110_AsBuilt_081518.dwg

FILE; S: \Construction\New Jersey\University Square\Regional\PROPO

DRAWN BY: DB

SCALE: N/A DATE: Aug 15, 2018

DRAWING NUMBER:

SK-1