


SUITE #280
UNIVERSITY SQUARE
PRINCETON, N.J.

KEY PLAN:

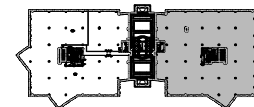

FILE NAME: 1U_280.dwg	EX-1
FILE: S:\Construction\New Jersey\University Square\Regional\Asbuilt\	
DRAWN BY: DB	
SCALE: N/A	
DATE: Feb 28, 2017	
DRAWING NUMBER:	