


**SUITE No. 275,  
300 Executive Drive,  
West Orange, NJ 07052**

KEY PLAN

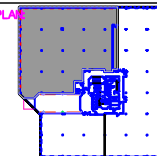

FILE NAME: 300-275.dwg

FILE: G:\West Jersey\300 EXECUTIVE DRIVE\Regional\asbun\

DRAWN BY: CJK

SCALE: NTS

DATE: Jan 14, 2010

DRAWING NUMBER:

**EX-1**