


SCALE: 1/64"=1'-0"



SCALE: 1/8"=1'-0"

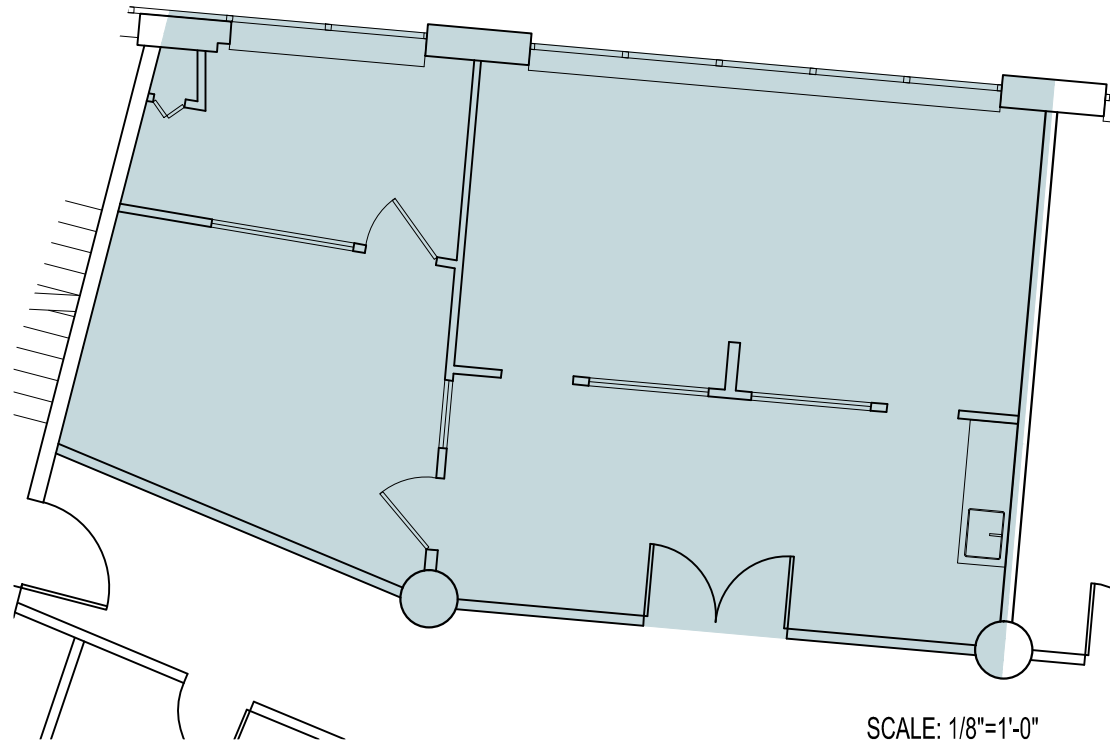

PROJECT LOCATION		B:\Construction\Hempstead\37-18 3rd Floor\Regional\3rd Floor\37-18 Northern Blvd - 3rd Floor AS-BUILT.dwg	
FILE NAME	PLOT DATE		
DATE	Jan 14, 15	DRAWING NO.	
DRAWN BY	classal	<b>DS-</b>	