


SUITE # 200
 48 SOUTH SERVICE ROAD
 MELVILLE, Y 11747

KEY PLAN :

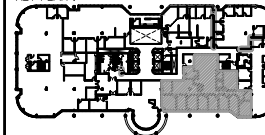

FILE NAME: 48-2nd Floor Asb/Building

FILE: S:\Construction\Long Island\48 South Service Rd\Building Asb/

DRAWN BY: PR

SCALE: 3/32"=1'-0"

DATE: SEPT 11, 2018

DRAWING NUMBER:

EX-1