



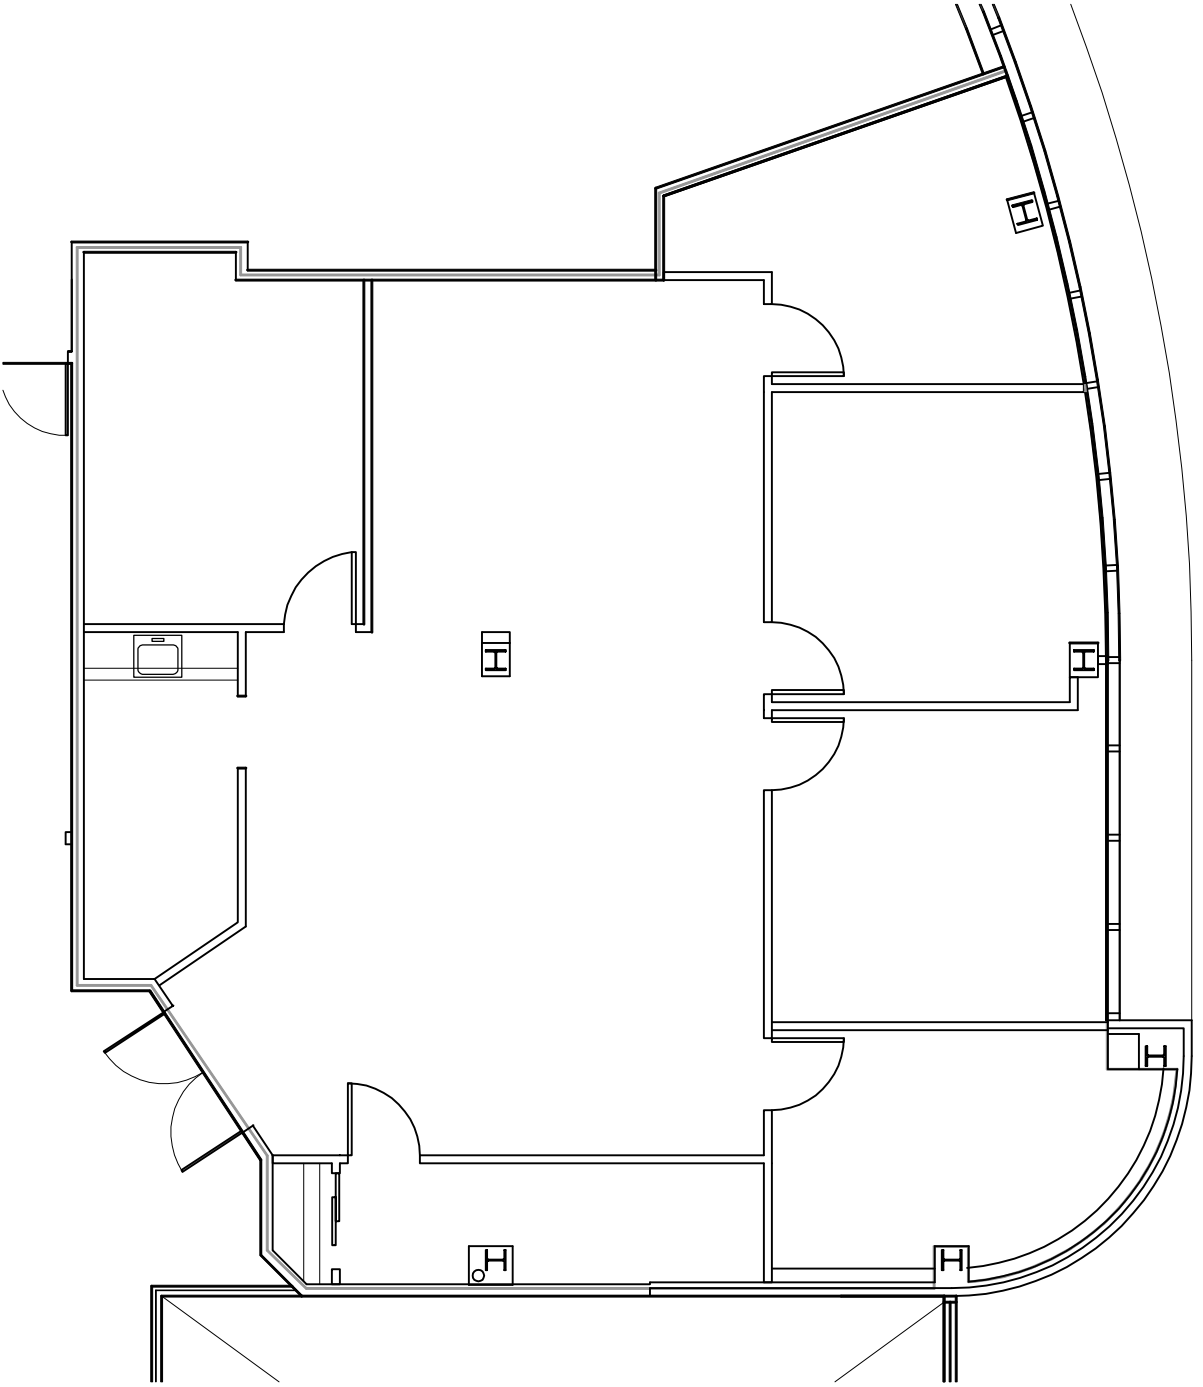

SUITE # 200
 50 CHARLES LINDBERGH BLVD
 UNIONDALE, NY 11554

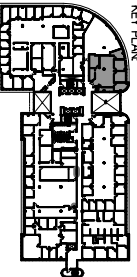

KEY PLAN



FILE NAME: 50_Charles_Floor_Architecting

FILE: 50_Construction/Architecting/500200 Charles Lindbergh Building

DRAWN BY: BM

SCALE: 1/8"=1'-0"

DATE: Apr. 28, 2014

DRAWING NUMBER:

EX-01