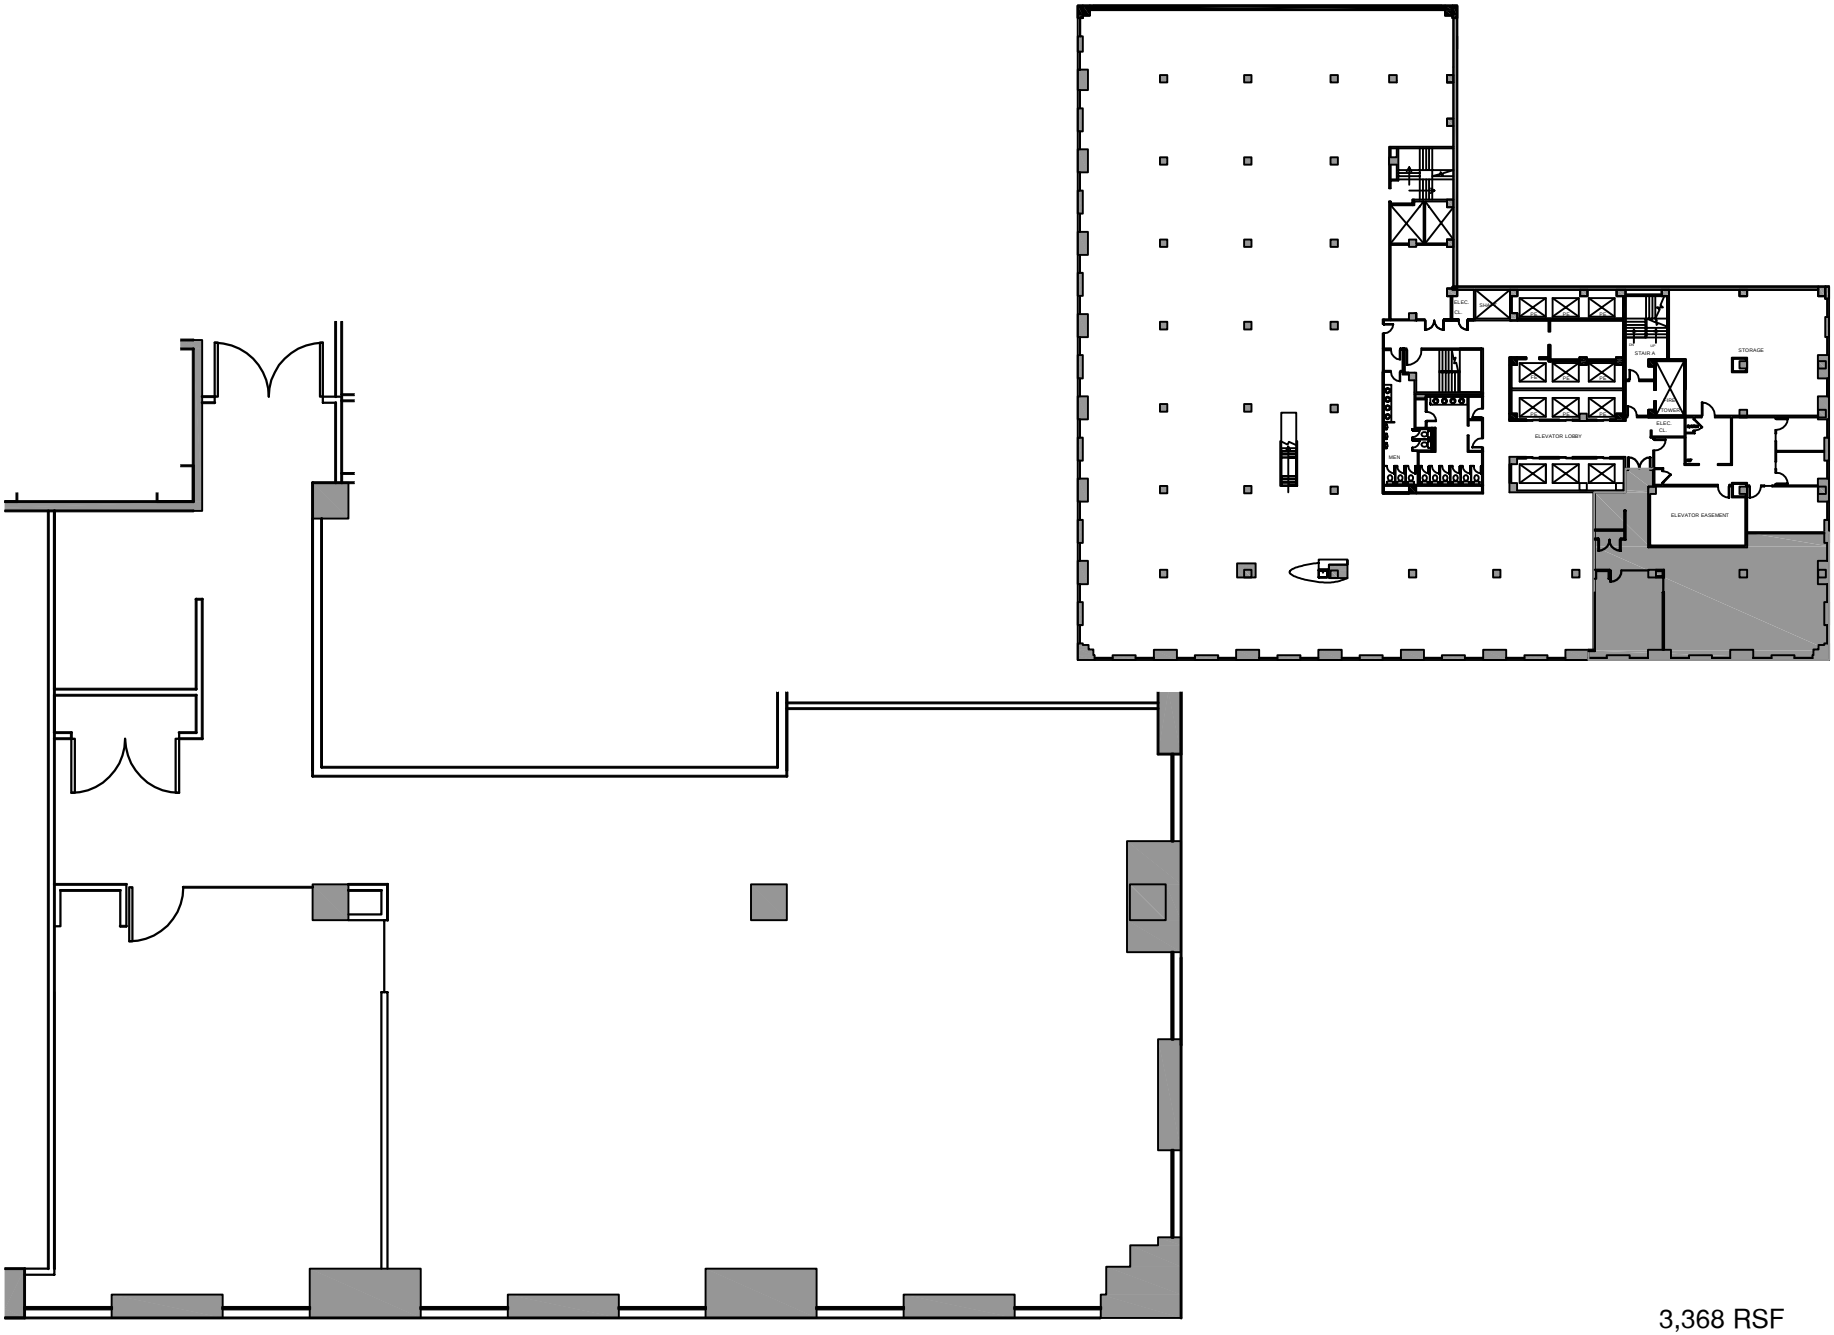

3,368 RSF

SCALE: 3/32" = 1'-0"

RXR CONSTRUCTION & DEVELOPMENT

SUITE 310

AS BUILT

3RD FLOOR
530 FIFTH AVENUE
NEW YORK, NEW YORK

PROJECT LOCATION S:\Construction\Manhattan\530 5th Avenue\Regional\Suite 310\		
FILE NAME 530-3 FL_Suite 310_12.05.14_05Feb03, 2014 - 1:41pm	PLOT DATE	
DATE	Dec 05, 14	DRAWING NO.
DRAWN BY	krbauer	DS-1