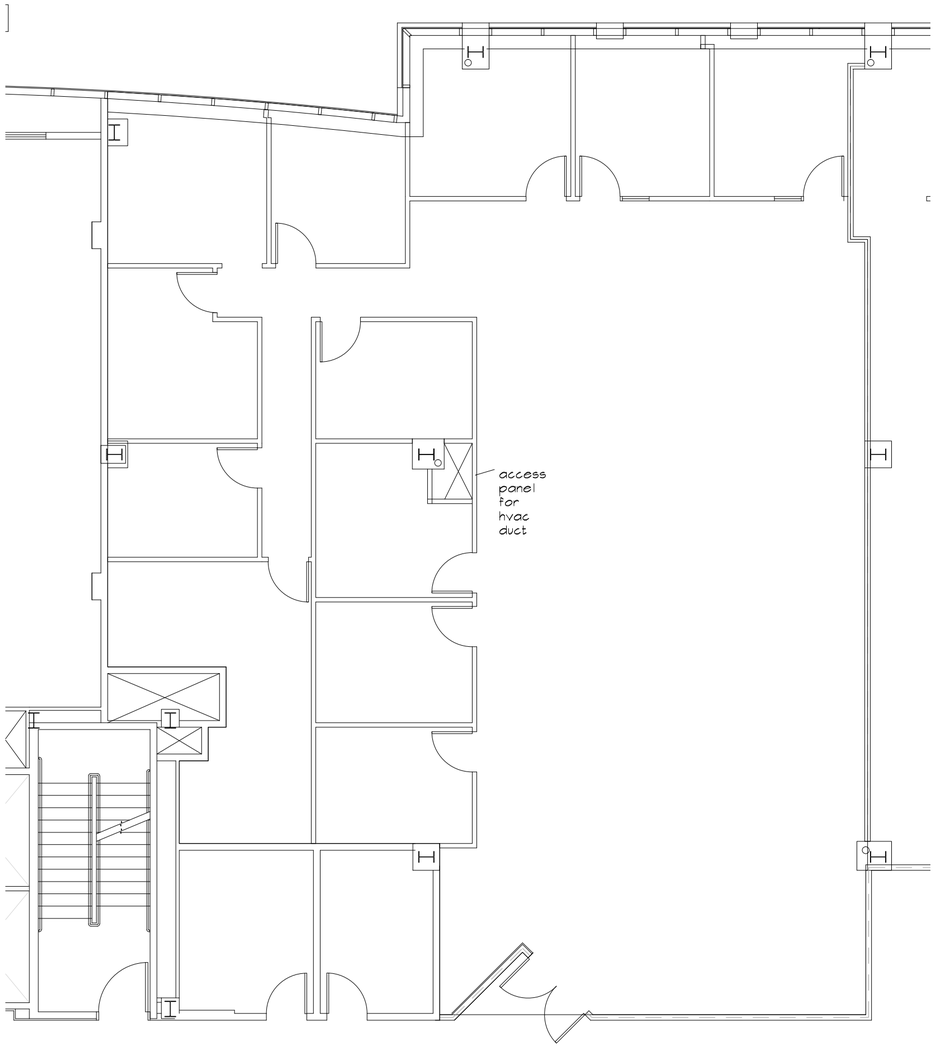

SUITE # 230
58 S.S. ROAD
MELVILLE, NY 11747

RXR

RXR
CONSTRUCTION & DEVELOPMENT

625 RXR PLAZA
UNIONDALE, NY 11556
(516) 506-6000

NO.	DATE	BY	REVISION

THESE DRAWINGS HAVE BEEN PREPARED UNDER MY DIRECT SUPERVISION.

SEAL

PROJECT TITLE

X
X

DRAWING TITLE

ASBUILT

PROJECT LOCATION
D:\Long Island\58 South Service Road\REGIONAL\as-built\

FILE NAME
58 SSR-Suite 230.dwg

PLOT DATE
Jan 07, 2014 - 2:54pm

DATE	Jan 07, 14	DRAWING NO.
DRAWN BY		A-1
SCALE	1/8" = 1'-0"	
ACT. #	XXXXX	1 OF 1